
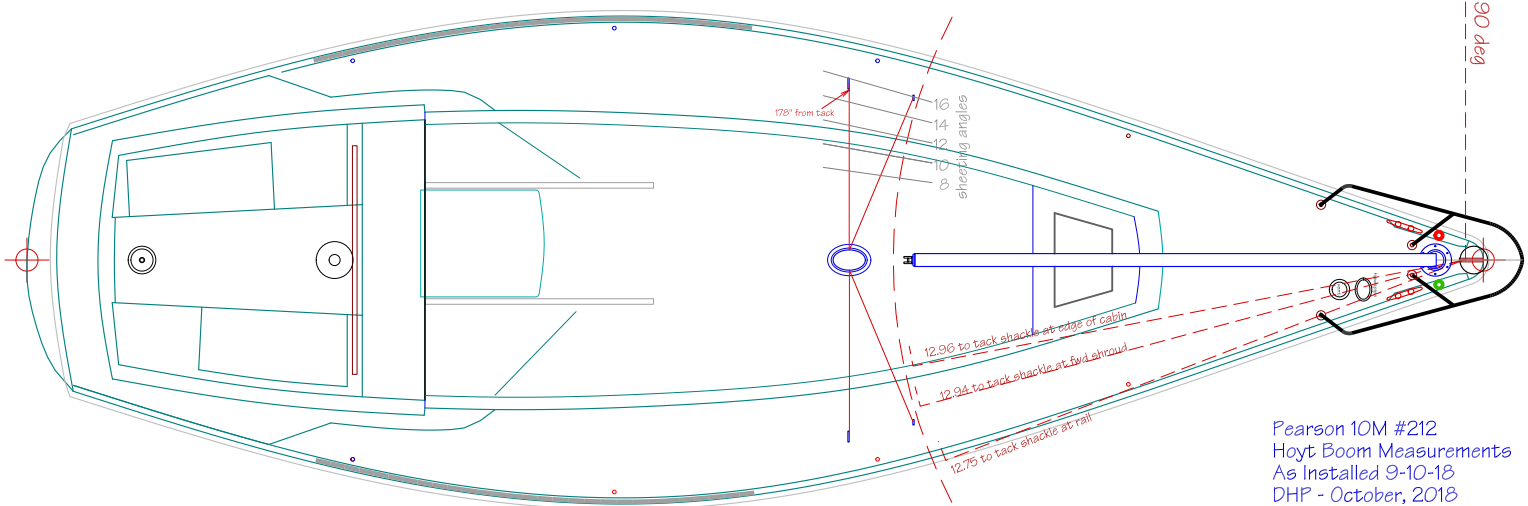


I = 44.5 (#212)
 J = 14.2
 P = 38.5
 E = 11.0
 SA = 524
 SAD=15.6, D/L=245
 LOA = 33.05
 BEAM = 11.0
 LWL = 28.33
 DRAFT = 5.83
 DISP = 12,500

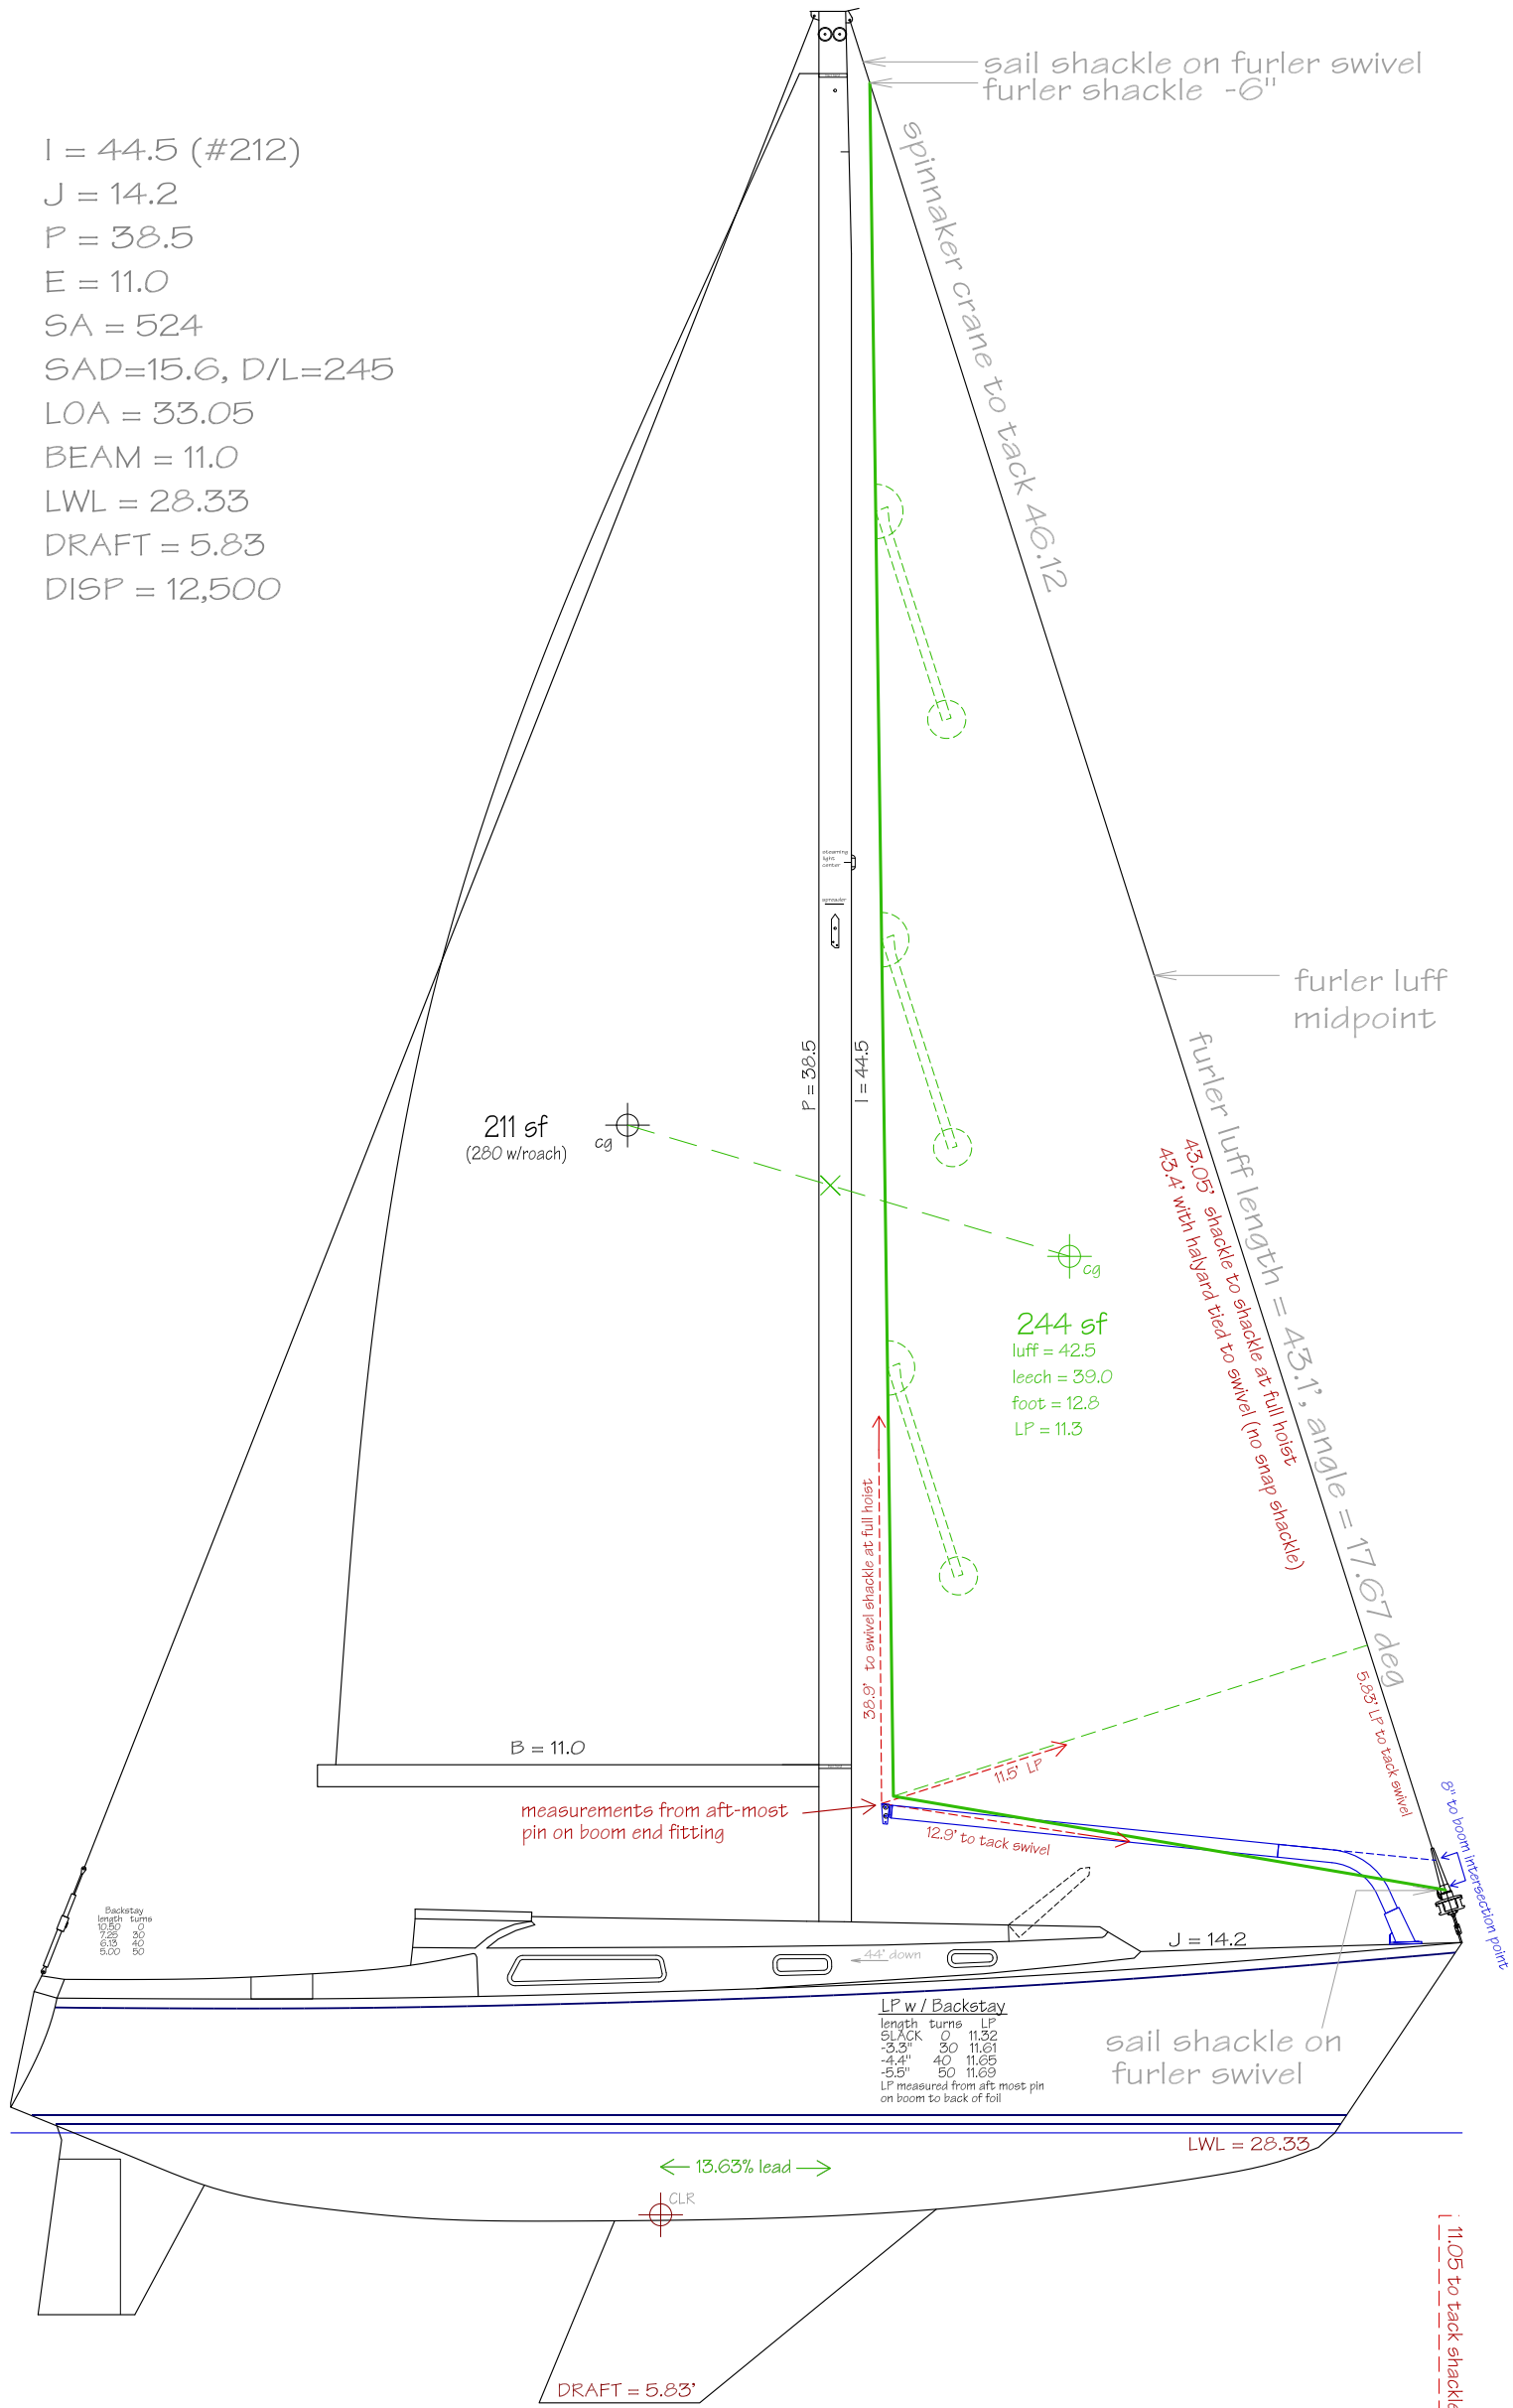

Pearson 10M #212
 Hoyt Boom Measurements
 As Installed 9-10-18
 DHP - October, 2018